


2703 SATURN STREET  
BREA, CA 92821  
TEL: (714) 524-9100

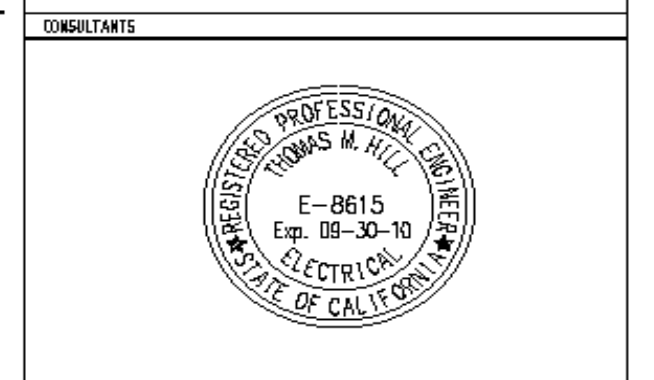

POJOAQUE PUEBLO SERVICES  
435 CONTRACTORS HILL ROAD,  
P.O. BOX 92  
EDWARDS AIR FORCE BASE  
CALIFORNIA 93523-8450

REPAIR HVAC  
BUILDING 1408

11/2009	As-Built Drawings
07/08/2009	095% (0)
07/29/09	100% (0)
DATE	DESCRIPTION
PROJECT NO:	PESH#4134
CAD FILE:	0-DEM EXISTING DEMO PLAN.DWG
DRAWN BY:	
CHECKED BY:	
COPYRIGHT:	

EXISTING DEMO PLAN

E-200

As-Built Drawings