

GAS HOT WATER BOILERS SCHEDULE

B UNIT	MANUFACTURER & MODEL NO.	LOCATION	TYPE	INPUT MBH	OUTPUT MBH MAX./DESIGN	% EFF.	PD (FT)	GALLON	GPM	HW ENT. °F	HW LVG. °F	MOTOR				VENT INCHES	OPER. WT. (LBS.)	REMARKS
												FLA	VOLT	PH	HZ			
B-1	RAYPAK H3-0402B	BLDG. 1408 MECH. ROOM ZN 1	GAS	399	335/323	84	MAX 7.2 MIN 0.8	2.4	MAX 34 MIN 32	160	180	15.5	120	1	60	6	575	① THRU. ⑧
B-2	RAYPAK H3-0302B	BLDG. 1408 MECH. ROOM ZN 2	GAS	500/	252/212	84	MAX 7.2 MIN 0.8	2.7	MAX 25 MIN 21	160	180	15.5	120	1	60	5	500	① THRU. ⑧

NOTES:

- ① PROVIDE BOILER WITH LOW NOX EMISSIONS.
- ② PROVIDE COLD START KIT BYPASS KIT AND LPV.
- ③ SCHEDULE FLA INCLUDE BOILER CONTROLS 6.7 FLA AND CP 8.8 FLA
- ④ INDOOR BOILER. PROVIDE WITH FACTORY INLET AIR FILTER AND FILTER BOX
- ⑤ PROVIDE ALL TRIM PER MANUFACTURERS RECOMMENDATIONS AND PER CALIFORNIA CODE REQUIREMENTS.
- ⑥ SCHEDULE OPERATING WEIGHT INCLUDES ALL ACCESSORIES.
- ⑦ PROVIDE BOILER WITH LOW TEMPERATURE SWITCH, ALARM BELL, FLOW SWITCH, MANUAL LIMIT TOGGLE SWITCHES
- ⑧ PROVIDE BOILER SYSTEM CIRCULATING (CP) PUMP SIZED PER MANUFACTURERS RECOMMENDATIONS

EXPANSION TANK SCHEDULE

ET SYMBOL	MANUFACTURER & MODEL NO.	SERVICE AND LOCATION	EXPANSION CAPACITY (GAL)	OPER. WT (LBS)	REMARKS
ET-1	TACO CBX84-3B	B-1 HW SYSTEM	22	150	BLADDER TYPE
ET-2	TACO CBX84-3B	B-2 HW SYSTEM	22	150	BLADDER TYPE

AIR SEPARATOR SCHEDULE

AS SYMBOL	MANUFACTURER & MODEL NO.	SERVICE AND LOCATION	CAPACITY (GPM)	P.D. (FT.)	OPER. WT. (LBS.)	REMARKS
AS-1G	TACO AC2F4	B-1 HW SYSTEM	-	-	-	①
AS-1G	TACO AC2F4	B-2 HW SYSTEM	-	-	-	①

- NOTES:** ① ASME SECTION VIII IN LINE CONSTRUCTION WITH STRAINER.

PIPING SCHEDULE

GPM RANGE	SIZE (INCH)
0 - 3	3/4
3.1 - 5.6	1
5.7 - 18	1-1/2
19 - 35	2
36 - 56	2-1/2
57 - 102	3
103 - 208	4
209 - 617	6
618 - 1,275	8
1,276 - 2,320	10
2,321 - 3,525	12

PUMPS SCHEDULE

HWP SYMBOL	TOTAL QNTY.	MANUFACTURER MAKE & MODEL	SIZE	MOTOR FRAME	BUILDING AND LOCATION	SERVICE	G.P.M.	TOTAL HEAD (FT)	PUMP RPM	MOTOR				OPER. WT (LBS)	REMARKS		
										BHP	HP	FLA	VOLT			PH	HZ
HWP-1	1	TACO FI-1509-7.8	2.5x1.5	145T	1408 MECH. ROOM	HOT WATER SYSTEM	75	62	1800	-	3	-	208	3	60	200	① ②
HWP-2	1	TACO FI-1507-7.3	2.5x1.5	145T	1408 MECH. ROOM	HOT WATER SYSTEM	75	53	1800	-	3	-	208	3	60	200	① ②
CP-1	2	BY BOILER MANUFACTURER	-	-	1408 B-1 BOILER PIPING	B-1A & 2A BOILER SYSTEM	74.7	7.9	-	-	-	8.8	120	1	60	50	③
CP-2	2	BY BOILER MANUFACTURER	-	-	1408 B-2 BOILER PIPING	B-1G & 2G BOILER SYSTEM	21.8	0.5	-	-	-	8.8	120	1	60	50	③

- NOTES:** ① WITH SUCTION DIFFUSER MP VALVE AND FLEXIBLE CONNECTIONS. ② SCHEDULE OPERATING WEIGHT INCLUDES ALL ACCESSORIES. ③ PROVIDED AND SIZED BY BOILER MANUFACTURER SEE BOILER NOTES ABOVE.

CHEMICAL FEEDER SCHEDULE

CSF SYMBOL	SERVICE	MAKE & MODEL	LOCATION	CAPACITY (GAL)	FLANGE SIZE	REMARKS
HSF-1	HOT WATER B-1	CHARDON LABS	MECH ROOM	5	NONE	①
HSF-2	HOT WATER B-2	CHARDON LABS	MECH ROOM	5	NONE	①

- NOTES:** ① PROVIDED AS PART OF THE HOT WATER SYSTEM


HOT WATER COIL SCHEDULE (EXISTING AH)

HC SYMBOL	TOTAL QNTY.	MANUFACTURER & MODEL NO.	LOCATION	SERVICE	CFM (EA)	CAP. (MBH) (EA)	GPM (EA)	ROWS-FINS/FT (EA)	ENT. WATER /LVG. WATER (°F) (EA)	WATER PD (FT) (EA)	CONN. PIPE SIZE (EA)	ENT. AIR /LVG. AIR (°F) (EA)	AIR PD (FT) (EA)	OPERATING WEIGHT (LBS.) (EA)	ANCHORAGE DETAIL (EA)	COIL SIZE (EA)	REMARKS (EA)
HC-1	1	TRANE D5WB18	(E) TRANE AH UNITS SIZE 06	EXISTING AH-1	3,000	107.4	4.75	1-135	180/160	0.07	1-1/2	45/78	0.20	80	COIL SECTION IN (E) UNIT	FIT UNIT SIZE	① ③ ④ ⑤ ⑥
HC-2	1	TRANE D5WB18	(E) TRANE AH UNITS SIZE 10	EXISTING AH-2	4,400	178.9	6.97	1-112	180/160	0.17	2-00	45/78	0.24	65	COIL SECTION IN (E) UNIT	FIT UNIT SIZE	① ③ ④ ⑤ ⑥
HC-3	1	TRANE D5WB18	(E) TRANE AH UNITS SIZE 12	EXISTING AH-3	6,000	214.7	9.51	1-113	180/160	0.84	2-1/2	45/78	0.30	70	COIL SECTION IN (E) UNIT	FIT UNIT SIZE	② ③ ④ ⑤ ⑥

- NOTE :** ① REPLACE EXISTING DUCT STEAM COIL WITH NEW HW COILS. ② ADD NEW COILS TO EXSTING TRANE AH UNITS. ③ HOT WATER GPM ARE BASED ON 180°F HWS AND 160°F HWR. ④ PROVIDE WITH 304 STAINLESS STEEL DRAIN PAN. ⑤ SCHEDULE OPERATING WEIGHT INCLUDES ALL ACCESSORIES. ⑥ RATING MBH IS BASED ON THE EXISTING SYSTEMS AIR HANDLERS CFM AND NEW ESTIMATED HEAT LOADS

CAMARILLO OFFICE
 11111 CAMARILLO AVENUE, SUITE 201
 CAMARILLO, CA 93025
 TEL: (805)987-4001
 FAX: (805)987-4044

BUDLONG & ASSOCIATES, INC.
 CONSULTING ENGINEERS
 WWW.BUDLONG.COM

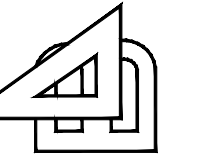

DESIGN FOR:
BUILDING 1408
REPLACE CHILLER, BOILER AND AHU'S
 EDWARDS AIR FORCE BASE, CALIFORNIA 93523-8450

QUOTE/DWG #:

DRAWN BY:

TS

CHECKED BY:

DATE:

12/05/2008

SCALE:

AS NOTED

REVISION HISTORY

1

2

3

4

5

PROJECT

FA9301-06-D-0010

M1.1

RECORD DRAWINGS

SUBMITTED 11/21/2008



PRIME CONTRACTOR: POJUAQUE PUEBLO SERVICES