AIR CONDITIONING UNIT SCHEDULE

	AC\	MANULEA OTUDED			SUPPLY FA	AN DATA			CO	DLING			ا بم	HEATING GAS (MBTUH)		TERS V-8)	UNIT ELECT		CONTROLS	REFRIGERANT	ADED	
S	MBOL	MANUFACTURER & MODEL NO.	SERVICE	LOCATION	DRIVE CFM	E.S.P. IN. W.G.	BHP MIN. OSA CFM	TOTAL MBTUH)	SENSIBLE (MBTUH) D	EAT B WB	LAT DB		FR/ 📙	NPUT OUTPUT	·	\leftarrow COMP.(S)	IFM POWER FLA USTER		CONTROLS REFRIGERANT OPER. WT. (LBS)	WT.	REMARKS	
	C-1	TRANE YSC072	1408 CONF/WORK	GRADE	BELT 2,400	0.8	1.07 400	68.24	56.69 78	00 62.80	55.25 5	2.24 1	1.0/ 1.5	80.0 64.80	4	16x25x2 1 10.6	- 4.0 19.6	23.2 34.0 460 3 60	PROGRA- MMABLE T'STAT	R-410A	2000	1 2 3 4 5 6 7 8 9 10 11

AC NOTES:

- 1) PROVIDE WITH 2" THROW AWAY FILTERS (MERV 81 TO MEET ASHRAE TEST STANDARD 52.2) AT MAXIMUN 300 FPM (650 CFM) EACH FILTER.
- 2 AMBIENT TEMPERATURE FOR DRY BULB COOLING IS 100°F FOR SELECTION OF ALL AC UNITS. DESIGN AMBIENT FOR "EAT" IS 102°F. MEAN COINCIDENT WET BULB VALUE IS 68°F.
- 3) THE AC UNITS SHALL BE MOUNTED ON LEVEL PREFABRICATED ISOLATION/SEISMIC CURBS COORDINATE INSTALLATION AND NEW LEVEL PAD WITH GENERAL CONTRACTOR.
- PROVIDE FREEZE STAT AT THE COOLING COIL DISCHARGE. DISPLAY ALARM MESSAGE ON ROOM THERMOSTAT.
- 5 PROVIDE UNITS WITH A 100% INTEGRATED MODULATING ECONOMIZER/ MODULATING POWER EXHAUSTER (CENTRIFICAL FAN TYPE) SYSTEM. ECONOMIZERS SHALL BE GEAR DRIVEN LINKAGE TYPE EQUIPPED WITH EXTRA LARGÉ RELIEF DAMPERS FOR UP TO 100% RELIEF CAPACITY.
- 6 PROVIDE STAND ALONE 7 DAY PROGRAMMABLE THERMOSTAT WITH LOCKING COVER AND WITH DISPLAYS.
- SCHEDULE OPERATING WEIGHT INCLUDES ALL
- PROVIDE STARTER WITH SINGLE POINT POWER CONNECTION MOUNTED AT UNIT WITH DISCONNECT. (SCHEDULE FLA, MCA AND MOCP INCLUDES ALL ACCESSORIES)
- PROVIDE WITH HIGH EFFICIENCY MOTOR(S).

- PROVIDE WITH VVT SYSTEM INCLUDING CONTROLS AND SENSORS
- PROVIDE SMOKE CONTROL PER CMC 609

														Α	IR HAI	NDLIN	G UN	ITS												
				SA FAN DATA				COOLING COIL DATA						HEATING COIL DATA				FILTERS		OUTSIDE AIR		UNIT ELECTRICAL		OPERATING		REMARKS				
$ \longleftrightarrow $	SERVICE	TYPE	LOCATION CFM	S.P.	CIZE N	MOTOR	CAPA	ACITY	ENT. C	1 -		WATER	RESS. DRO	PROWS	MAX.	CAPACITY	WAT	ER		DROP AIR		 FFF		(CFM)				OPERATING WEIGHT	SIZE	TREMINITION
SYMBOL				(IN.) EXT. TOTAL			SENSIRI E	TTOTAL BH)	AIR °F	→ W 下 	R °F WTR WTR (°F)	(GPM)	AIR WIR (IN.) (FT.)	-FPF	VELOCITY (FPM)	 MBH	ENT. LV	'G. F) GPM	AIR (IN.)	WTR ENT. LVG. (FT.) (°F)	ROWS	$\binom{C(\%)}{(\%)}$ QTY.	SIZE	MIN. EXIST. (T-24) (DESIGN)	MCA	FLA MOCC	C VOLT-PH-HZ	LBS. (MAX.)	(MAX.)	(SEE AH NOTES.)
				EXT. TOTAL	1 1		SENSIBLE	TOTAL	DD WD	() 00	WD (· /		· / MAX.		(FFM)	141511	() ()	/	<u> </u>					(= 1)(==1010)				(IVIAA.)	(WAX.)	
	ZONE 1 1ST FLOOR	BLOW THRU	1408 MECH. ROOM 21,550	1.8 3.5	25 25	5 19.8	332.9	332.9	 83.0 63.0) 44 68.9	57.7 55	66.6	0.27 2.53	3	575	206,895	180 16	0 21.0	0.4	1.1 65.0 75.0) 1	13 16	24X24X2	1913 2080	(1)		460-3-60	7000	L SHAPE MATCH EXISTING	① THRU. ⑨ ②
	131 I LOOK	1111110	NOOW											98															WATCH EXISTING	
	ZONE 2	BLOW	1408 MECH.									70.0		4					.			13 9							L SHAPE	O TUDU O O
AH-2	COMP. ROOM		ROOM 10,005	2.0 3.6	24 10	0 9.6	197.8	197.8	83.0 63.0	44 625.0	56.4 55	36.9	0.15 1.65	87	327	116,200	180 16	0 11.6	0.14	0.32 58.5 70.2	! 1		24X24X2	2877 2000			460-3-60	4500	MATCH EXISTING	① THRU. ⑧ ⑩

AH NOTES:

- 1) PROVIDE WITH INTERNAL ISOLATION AND SEISMIC RESTRAINT
- (2) HARDWIRE EXISTING SA & RA SMOKE DETECTOR TO AIR HANDLING UNIT SHUT-DOWN.
- (3) CONTROL PANEL MOUNTED AT UNIT
- (4) ALL CONTROL PROVIDED AND INSTALLED BY THE BASE CONTRACTED CLIMATEC CONTROL CONTRACTOR
- (5) UNIT SHALL BE OF SECTIONALIZED CONSTRUCTION (MAXIMUM 5 FOOT SECTIONS) TO FIT THRU EQUIPMENT ROOM DOOR.
- 6 CONTRACTOR SHALL RECORD EXISTING AHU CFM, WATER & AIR TEMPERATURES AND STATIC PRESSURE PRIOR TO DEMOLITION OF EXISTING UNIT.
- 7 PROVIDE WITH SINGLE POINT POWER CONNECTION
- (8) PROVIDE MOTORS WITH VFDS
- (9) PROVIDE WITH T-24 100% ECOMONIZERS AND CONTROLS
- 10 NO ECOMONIZER ON EXISTING UNIT
- 1 PROVIDED BY ELECTRICAL

- 12 PROVIDE WITH ZONE DAMPERS (to be field verified)
- (3) PROVIDE WITH 2" FILTER RACK AND 2" THROW AWAY FILTERS (MERV 7 TO MEET ASHRAE TEST STANDARD 52.2) AT MAXIMUM 300FPM (650CFM) EACH FILTER

		VV	T SC	CHEC	DULE					ME	CHA	ANIC	AL \	/EN	ΓALI	TION	/
А	MANUEACTURED				ОГИ	DANCE	MAX		В	С	D	E	F	G	Н	l	М
WT	MANUFACTURER	SIZE	LENGTH	WEIGHT		RANGE	DAMPER	REMARKS	COND.	CFM	MIN.	NUM.	CFM	MIN.			WT DMPR
	AND MODEL			LBS	MIN.	MAX.	SET CFM		AREA SQ.FT.	PER SQ.FT.	CFM AREA	OF PEOPLE	PER PEO.	CFM OCCUP.	V.A. MAX.	V.A. CFM	MIN. SET CFM
ZD1-1	ZD SEE NOTE #3	14"ø	20"	27	640	1710	1100	SEE WT NOTES.	600	.15	90	4	15	60	90	_	90
ZD1-2	ZD SEE NOTE #3	14"ø	20"	27	640	1710	1000	SEE WT NOTES.	300	.15	45	10	15	150	150	_	120
CV-3							300		400	.15	60	0	15	0	60	_	60
BP-6	BP SEE NOTE #3	20"ø	20"	30	470	2400	1500	SEE WT NOTES.									
									(1300)	_	(195)	(14)	_	(210)	(300)	(300)	_

WT NOTES:

- 1. 24VAC TRANSFORMER (FIELD SUPPLIED AND INSTALLTED).
- 2. PROVIDE 120V-1PHASE LESS THAN 1AMP. 3. ALL VVT BOXES SHALL BE WITH DDC CONTROL OR EQUAL.
- 4. ALL DAMPERS SHALL BE AS INDICATED OR EQUAL.
- 5. ALL DAMPERS SHOULD BE PROVIDED WITH 120V OR 24 VAC POWER.
- 6. PROVIDE TRANSITIONS FROM SCHEDULED CONNECTING DUCT SIZES TO DAMPER SIZES.


S	AREA SQ.FT.	PER SQ.FT.	CFM AREA	OF PEOPLE	PER PEO.	CFM OCCUP.	V.A. MAX.	V.A. CFM	MIN. SET CFM	
ΓES.	600	.15	90	4	15	60	90	-	90	
ΓES.	300	.15	45	10	15	150	150	ı	120	
	400	.15	60	0	15	0	60	1	60	
ΓES.										
	(1300)	ı	(195)	(14)	ı	(210)	(300)	(300)	1	
		TALS AF	RE SHO	WN AS: ((XXX).					
	FORMULA	\								ĺ

D=BxC G=ExF H=MAX. OF E OR G

I=SYSTEM MIN. OSA SETTING

			F	AIR OUT	LET	SCHE	DULE	· ·
					AT RATI	ED CFM	CONN	NOTE: FRAME TO MATCH THE CEILING T—BAR CLG./ADJUST DEFLECT.
SYMBOL	TYPE	NECK SIZE IN.	FRAME SIZE IN.	RATED CFM	MAX. PD IN.WG	MAX. NOISE CRITERIA	DUCT SIZE UON	T-BAR CLG./ADJUST DEFLECT. OF DIFFUSERS AS SHOWN ON DWGS. REMARKS
CD-1	SUPPLY	15X15	24X24	0-600	0.09	35	12"ø	KRUEGER PERFORATED TYPE 1100 W/ O.B.D. & R.N.R. WHERE REQD.
CD-2	SUPPLY	16 " ø	4 RING	0-1100	0.09	35	16"ø	KRUEGER ROUND TYPE RM1 W/ O.B.D.
CD-3	SUPPLY	8x6	10x8	0-460	0.09	35	8x6	KRUEGER SIDE WALL TYPE 880 W/ O.B.D.
RAR/ER-1	RETURN	22X22	24X24	1000-1300	0.09	35	16"ø	KRUEGER PERFORATED TYPE 1190 W/ O.B.D. & R.N.R. WHERE REQD.
RAR/ER-2	RETURN	22X22	24X24	1000-1300	0.09	35	16X16	

PRIME CONTRACTOR: POJOAQUE PUEBLO SERVICES

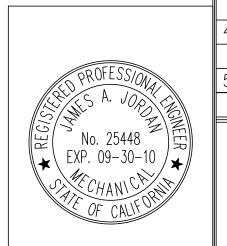

BUI REPLACE CHILL EDWARDS AIR FORG QUOTE/DWG #:

CHECKED BY:

12/05/2008 AS NOTED

REVISION HISTORY

PROJECT FA9301-06-D-0010

M1.3