



SYMBOL/ABBREVIATION	DESCRIPTION
(ER)	EXISTING TO REMAIN
(E)	EXISTING
(R)	REMOVE
(RL)	RELOCATED
(RS)	REMOVE & SAVE FOR RELOCATION
●	(POD) POINT OF DISCONNECT
⋯	EXISTING TO REMAIN (BROKEN)
////	EXISTING TO BE REMOVED (HATCHED)

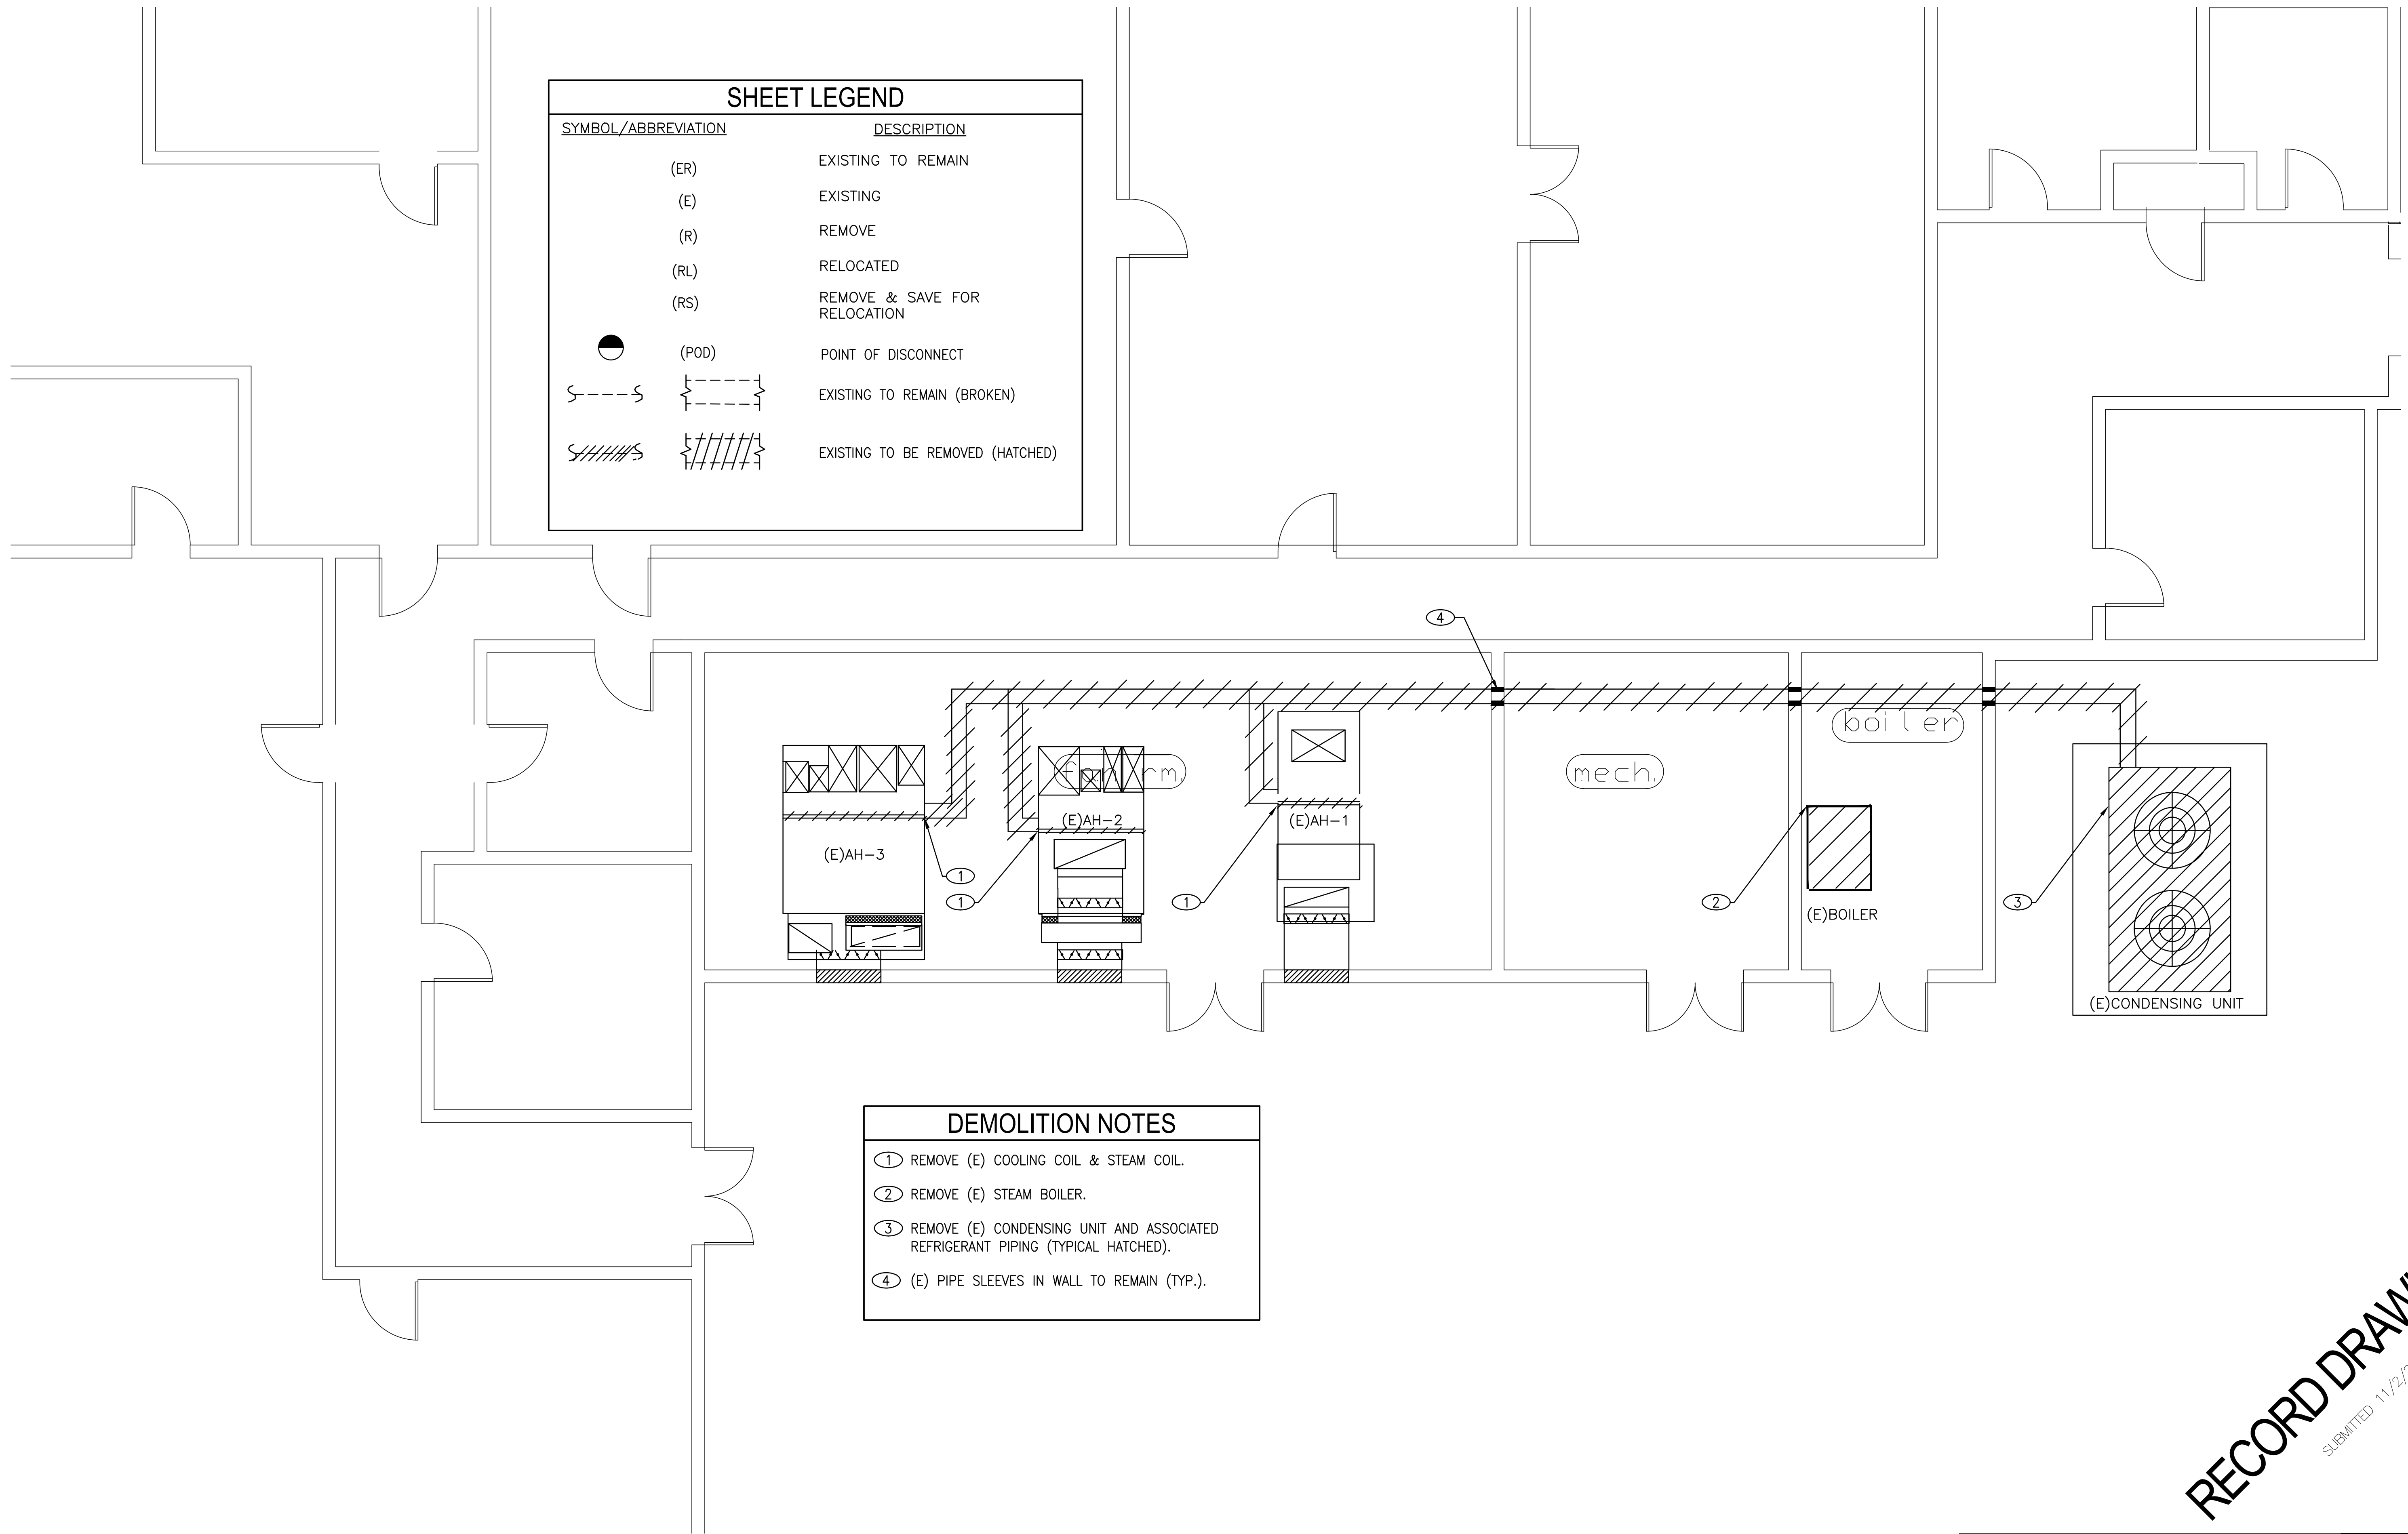

DEMOLITION NOTES	
①	REMOVE (E) COOLING COIL & STEAM COIL.
②	REMOVE (E) STEAM BOILER.
③	REMOVE (E) CONDENSING UNIT AND ASSOCIATED REFRIGERANT PIPING (TYPICAL HATCHED).
④	(E) PIPE SLEEVES IN WALL TO REMAIN (TYP.).

1  
-  
ZONE-2 MECHANICAL ROOM NEW WORK  
SCALE: 1/4"=1'-0"

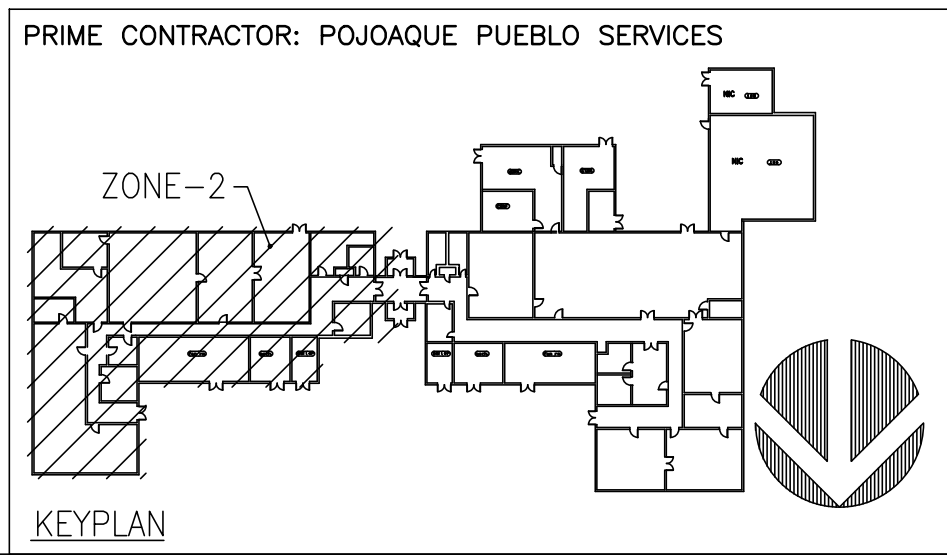

**RECORD DRAWINGS**  
SUBMITTED 11/21/2008

GLENDALE OFFICE  
SUITE 201  
11111 GLENDALE BLVD.  
GLENDALE, CA 91205  
TEL: (619) 948-9700  
FAX: (619) 948-9701

BUDLONG  
& ASSOCIATES, INC.  
CONSULTING ENGINEERS

DESIGN FOR:  
**BUILDING 1408**  
**REPLACE CHILLER, BOILER AND AHU'S**  
EDWARDS AIR FORCE BASE, CALIFORNIA 93523-8450

QUOTE/DWG #:

DRAWN BY:

TS

CHECKED BY:

DATE:

12/05/2008

SCALE:

AS NOTED

REVISION HISTORY

NO.	DESCRIPTION
1	
2	
3	
4	
5	

PROJECT

FA9301-06-p-0010

M2.2D