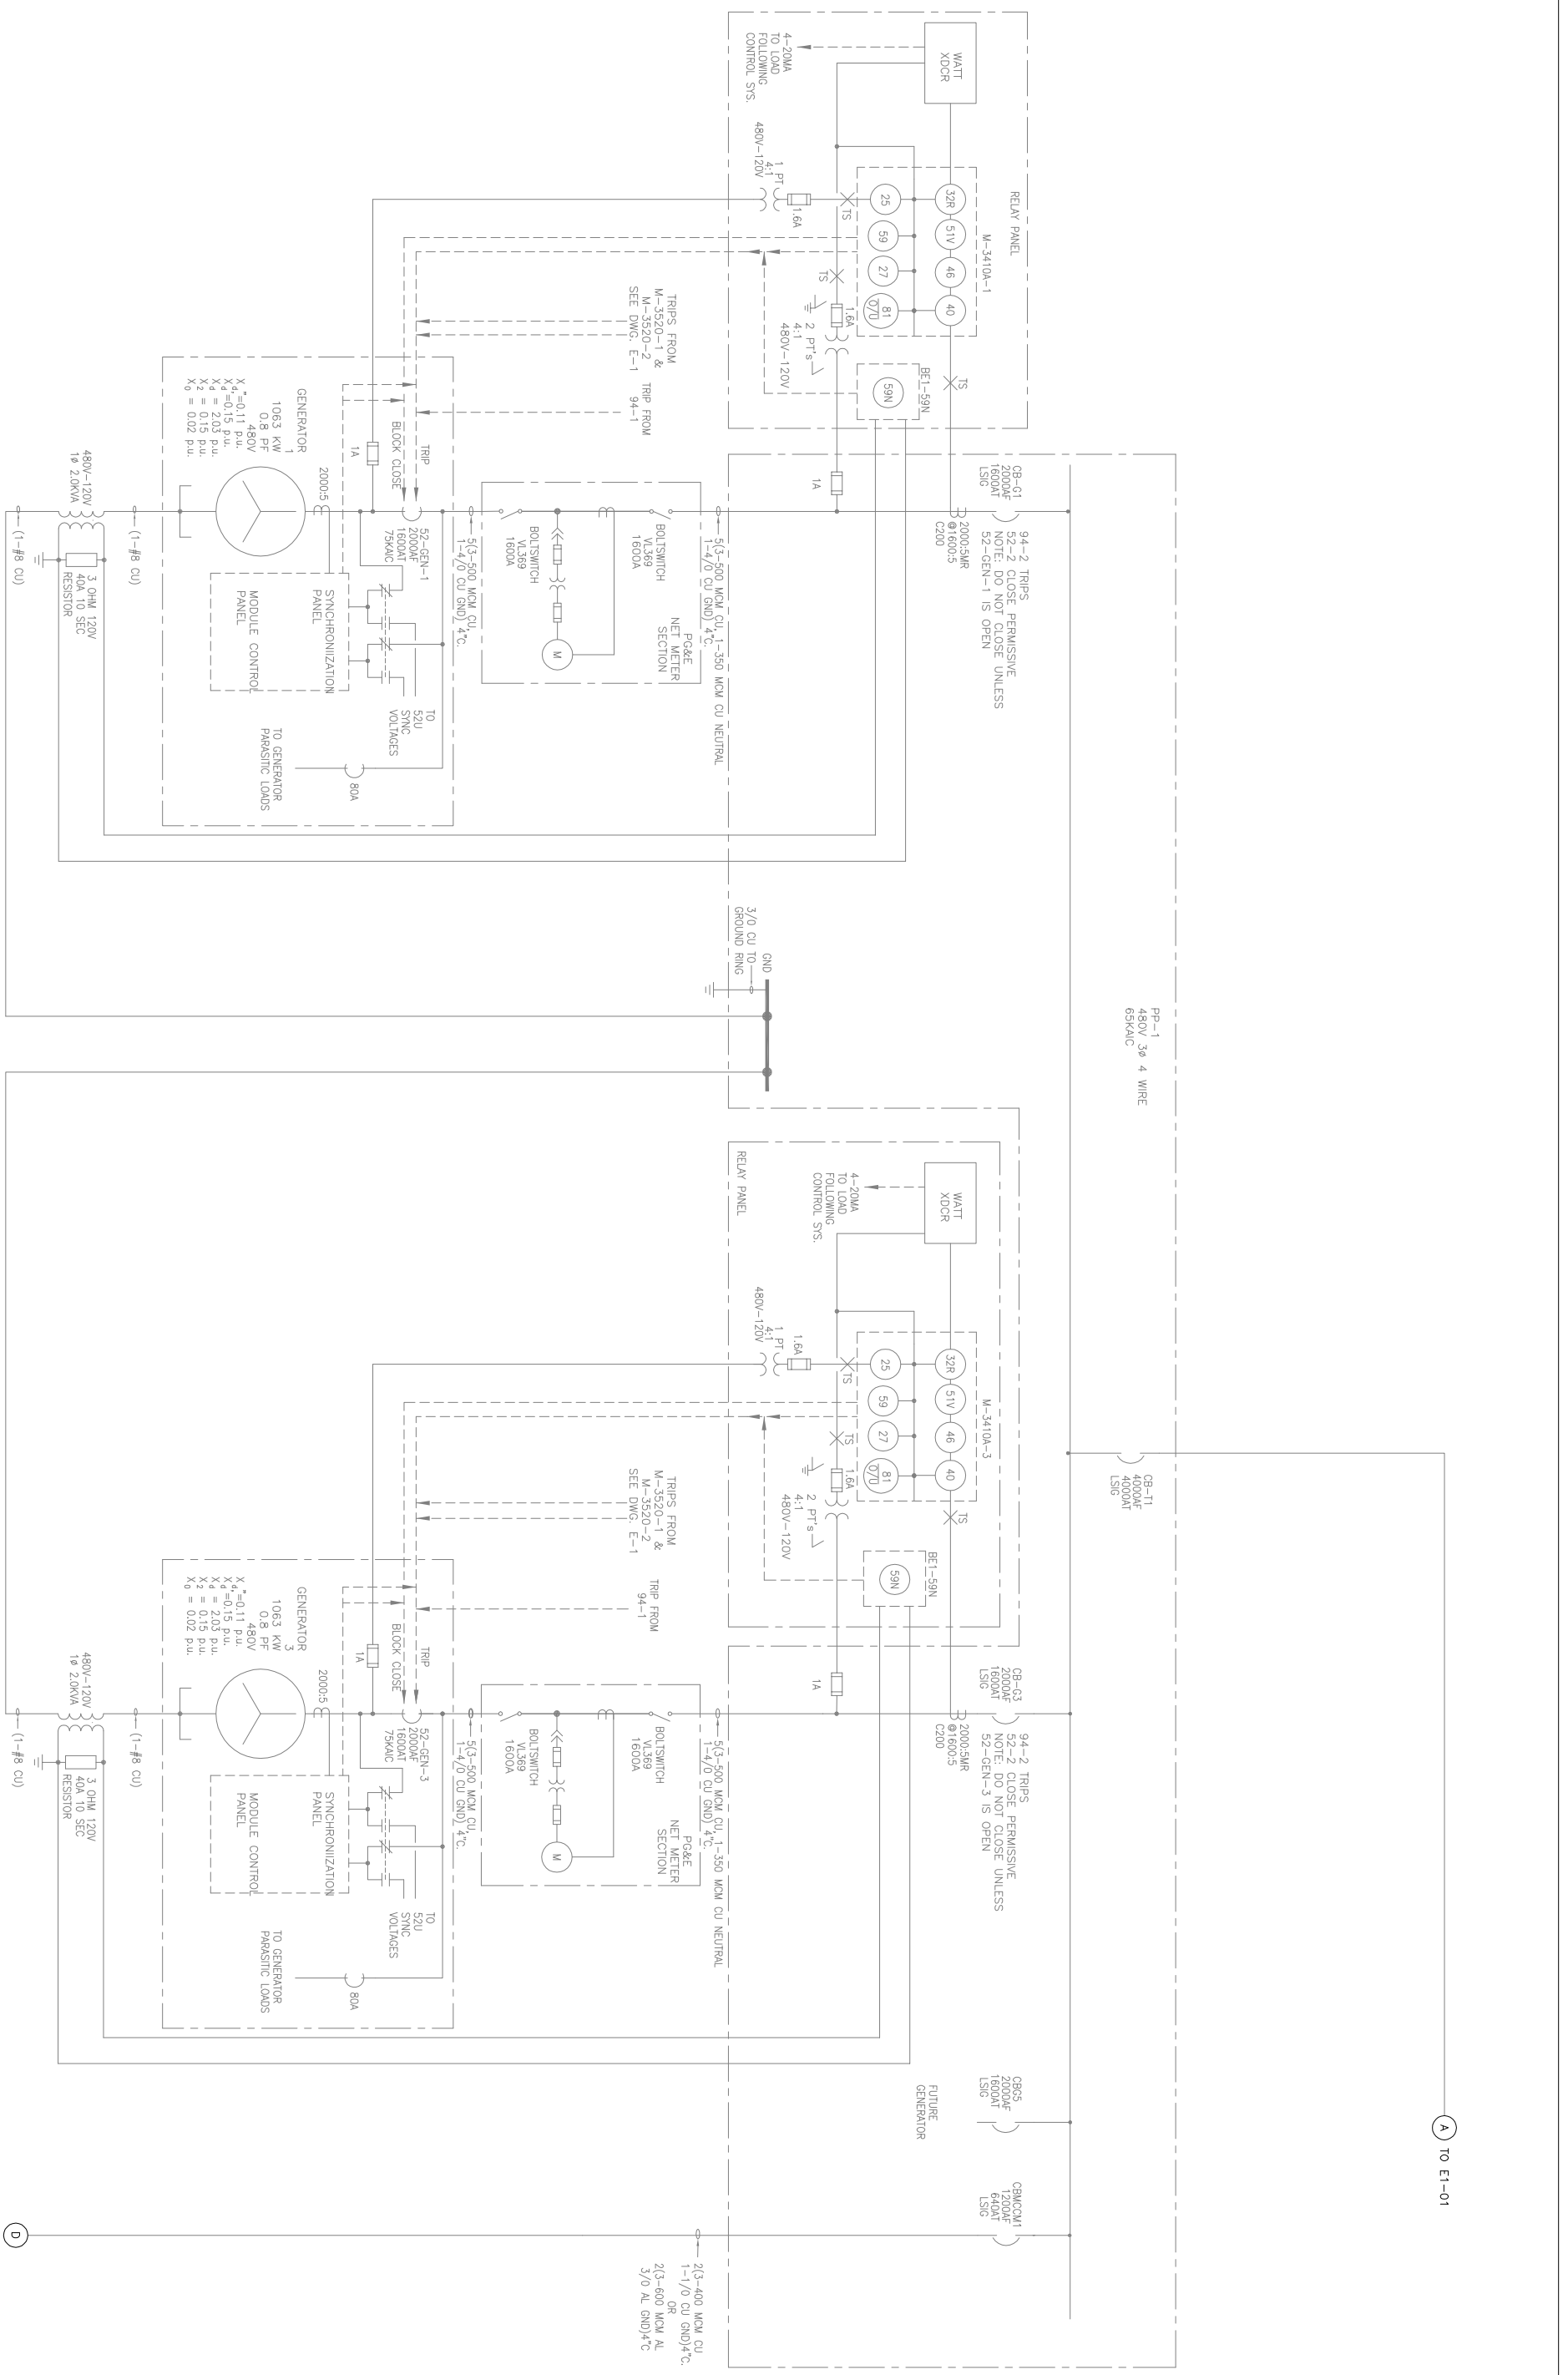

ENGINEERED BY	KM
DRAWN BY	GDY
CHECKED	JDB
DATE	4/3/12
SCALE	N/A
JOB NO.	2267

E1-03

mef incorporated
electric power engineering
P.O. Box 1265 Arvada, CO 80001
(303) 431-7895 FAX (303) 431-1836

GENERATION ADDITION

Colusa Indian Community Council 3730 Highway 45, Colusa, CA 95932

ONE-LINE DIAGRAM

NO.	DATE	DWN.	CHK.	REVISIONS
A	11/24/10	KM	KM	FOR REVIEW
B	8/5/11	KM	KM	ISSUED FOR PERMIT
C	7/17/12	GDY	GDY	RECORD DRAWING