CAUTION: IF THIS SHEET IS NOT 24"x36" IT IS A REDUCED PRINT. SCALE ACCORDINGLY.

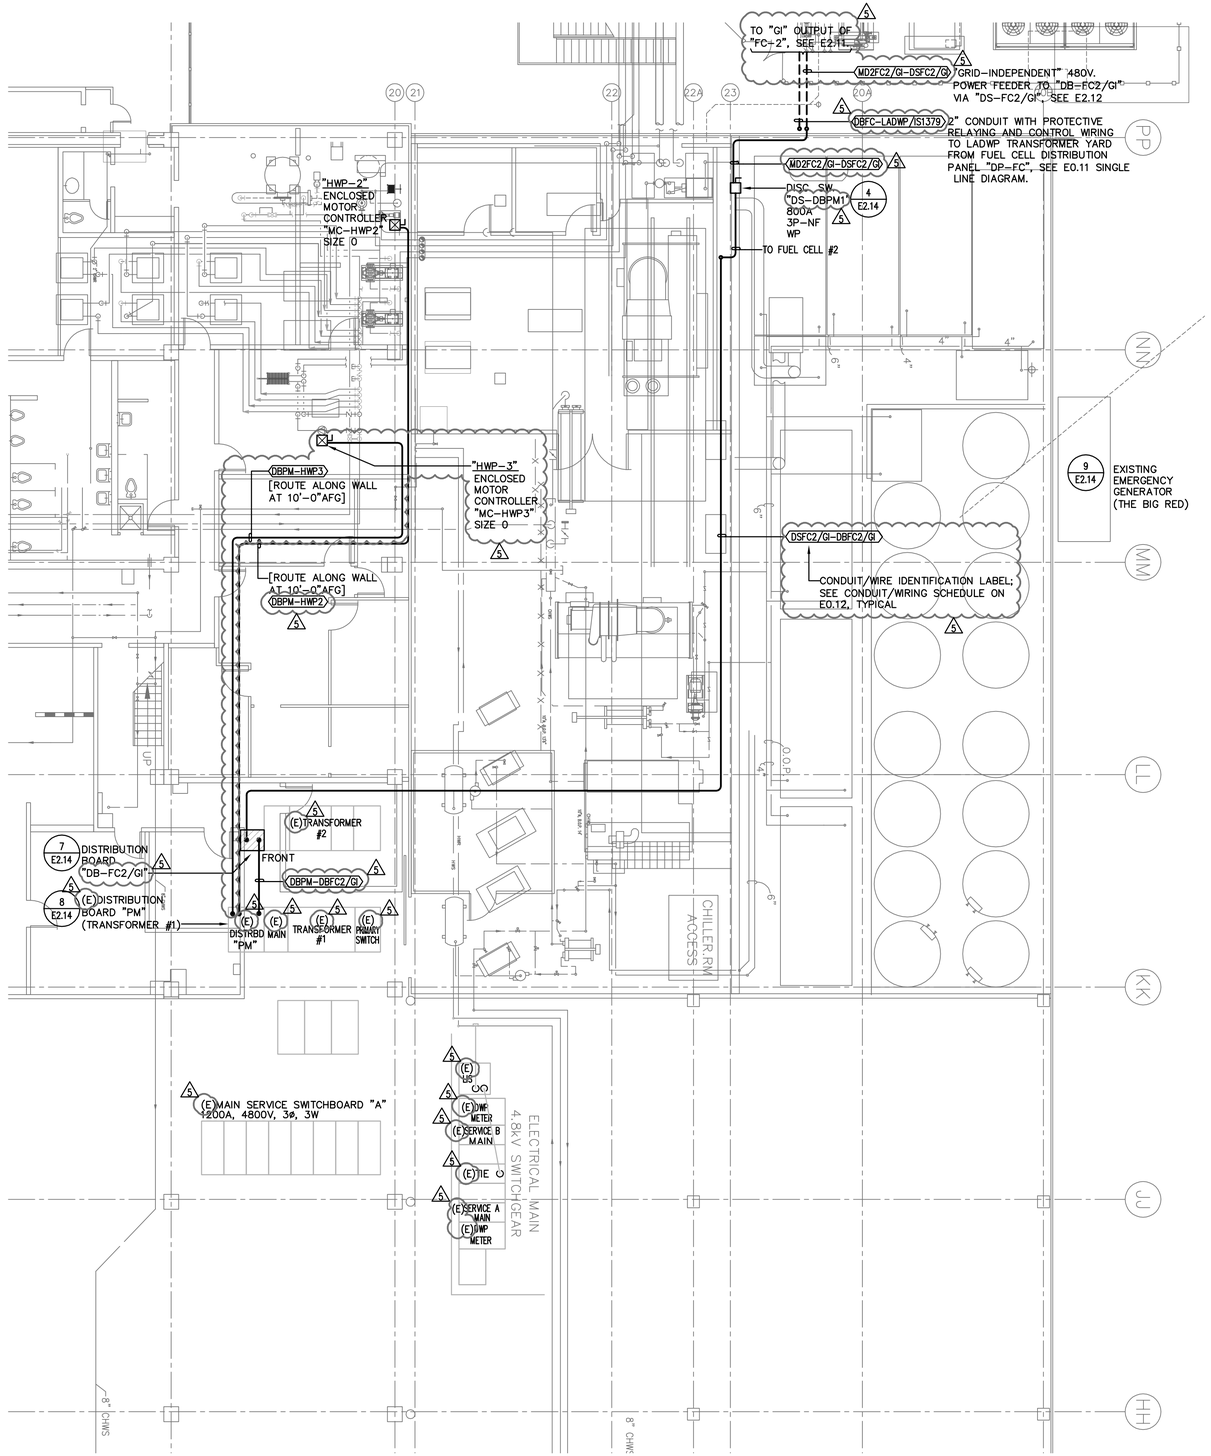

1 E2.12 **ELECTRICAL PLAN - SERVICE BUILDING**
SCALE: 1/8"=1'-0"

OMB ELECTRICAL ENGINEERS, INC.
8825 Research Drive
Irvine, CA 92618
(949) 753-1551 Fax (949) 753-1992
E-Mail: mail@ombengrs.com

KEYSTONE Engineering Solutions, Inc.
9550 Research Dr., Irvine, California 92618
www.kesolutions.com
This drawing and the design shown are the property of Keystone Engineering Solutions, Inc. Reproduction or other use of this drawing without their written consent is forbidden and any infringement will be subject to legal action.

CBS TELEVISION CITY
FUEL CELL INSTALLATION PROJECT
7800 BEVERLY BLVD.
LOS ANGELES, CALIFORNIA 90036

ELECTRICAL PLAN - SERVICE BUILDING

ID	DATE	REMARKS
1	7/02/12	PRELIMINARY DESIGN REVIEW
2	8/20/12	PLAN CHECK
3	9/4/12	BID CLARIFICATIONS
4	9/19/12	UTC RECOMMENDED CORRECTIONS
5	10/18/12	UTC, REV. PLAN CHECK CORRECTIONS

REGISTERED PROFESSIONAL ENGINEER
ROY L. LOPEZ
No. 13442
Exp. 09/30/14
ELECTRICAL
STATE OF CALIFORNIA

KEY PLAN

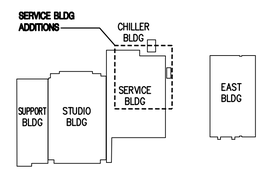

ENGR:	
DRWN BY:	TEAM 1
CHCK'D BY:	RLL
DATE:	9/19/12
JOB NO.:	12-010
SCALE:	AS NOTED

SHEET
E2.12

Last saved by genevieves Layout: K:\TEAM-1\V2168\work\V2168_E2.12.dwg 09/18/2012 10:22
Last plotted by genevieves Layout: K:\TEAM-1\V2168\cad\V2168_E2.12.dwg 12/07/2012 11:05