LEGEND:

EQUIPMENT TO BE REMOVED

DEMOLITION NOTES:

1. CONTRACTOR SHALL PERFORM CIRCUIT VERIFICATION TO IDENTIFY ALL LOADS CONNECTED TO THE PANELS TO BE REMOVED. ANY ACTIVE CIRCUITS IDENTIFIED SHALL BE BROUGHT TO THE ATTENSION OF THE PROJECT MANAGER.
2. EXISTING STARTERS TO BE REMOVED AND REPLACED BY HVAC VENDOR SUPPLIED VFDS.

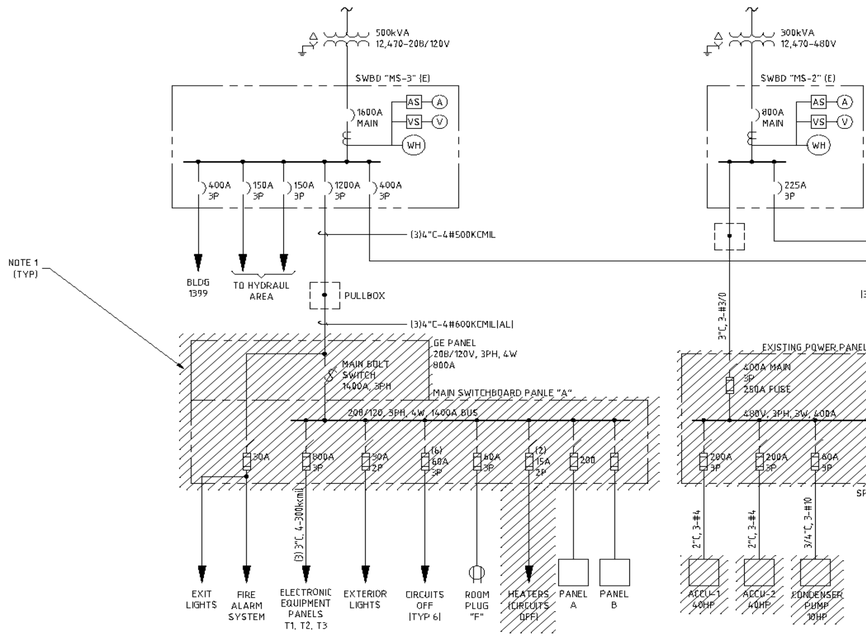

EXISTING PANELS TO BE REMOVED
BOILER ROOMWEST

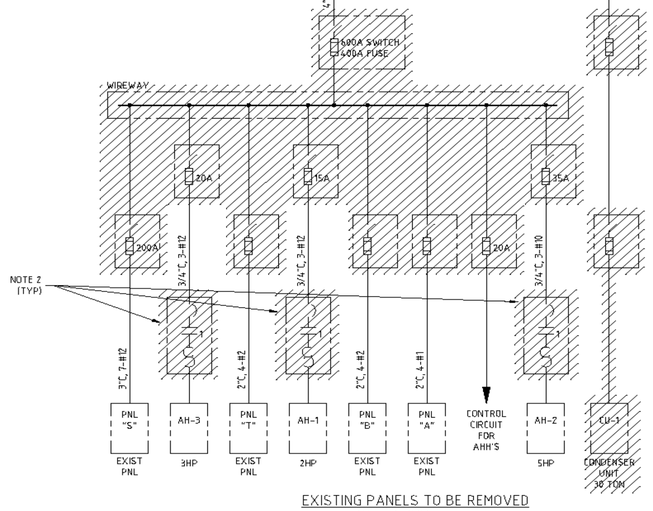

EXISTING PANELS TO BE REMOVED
BOILER ROOM EAST

As-Built Drawings

POWER ENGINEERING SERVICES INCORPORATED
2703 SATURN STREET
BREA, CA 92821
TEL: (714) 524-9100

CONSULTANTS

REGISTERED PROFESSIONAL ENGINEER
THOMAS M. HILL
E-8615
Exp. 08-30-10
ELECTRICAL
STATE OF CALIFORNIA

POJOAQUE PUEBLO SERVICES
435 CONTRACTORS HILL ROAD,
P.O. BOX 92
EDWARDS AIR FORCE BASE
CLIENT: CALIFORNIA 93523-8450

REPAIR HVAC BUILDING 1408

MARK	DATE	DESCRIPTION
	11/2/09	As-Built Drawing
C	6/28/09	95% CD
A	12/19/08	65% CD

PROJECT NO: PES#4134
CAD DWG FILE: E-100 EXISTING DEMO SINGLE-LINE.DWG
DRAWN BY:
CHKD BY:
COPYRIGHT:

SHEET TITLE
EXISTING DEMO SINGLE-LINE

SHEET E-100 OF