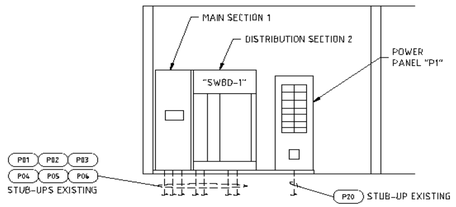

ELEVATION NEW MAIN DISTRIBUTION C

SCALE: 1/4" = 1'-0"

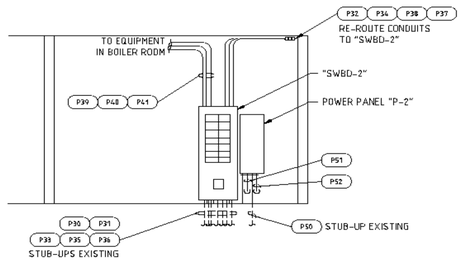

ELEVATION NEW POWER PANELS D

SCALE: 1/4" = 1'-0"

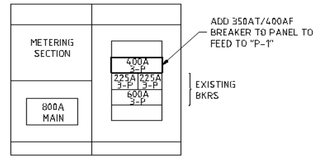

480V MAIN SWBD MS-2 EXISTING E

SCALE: NONE

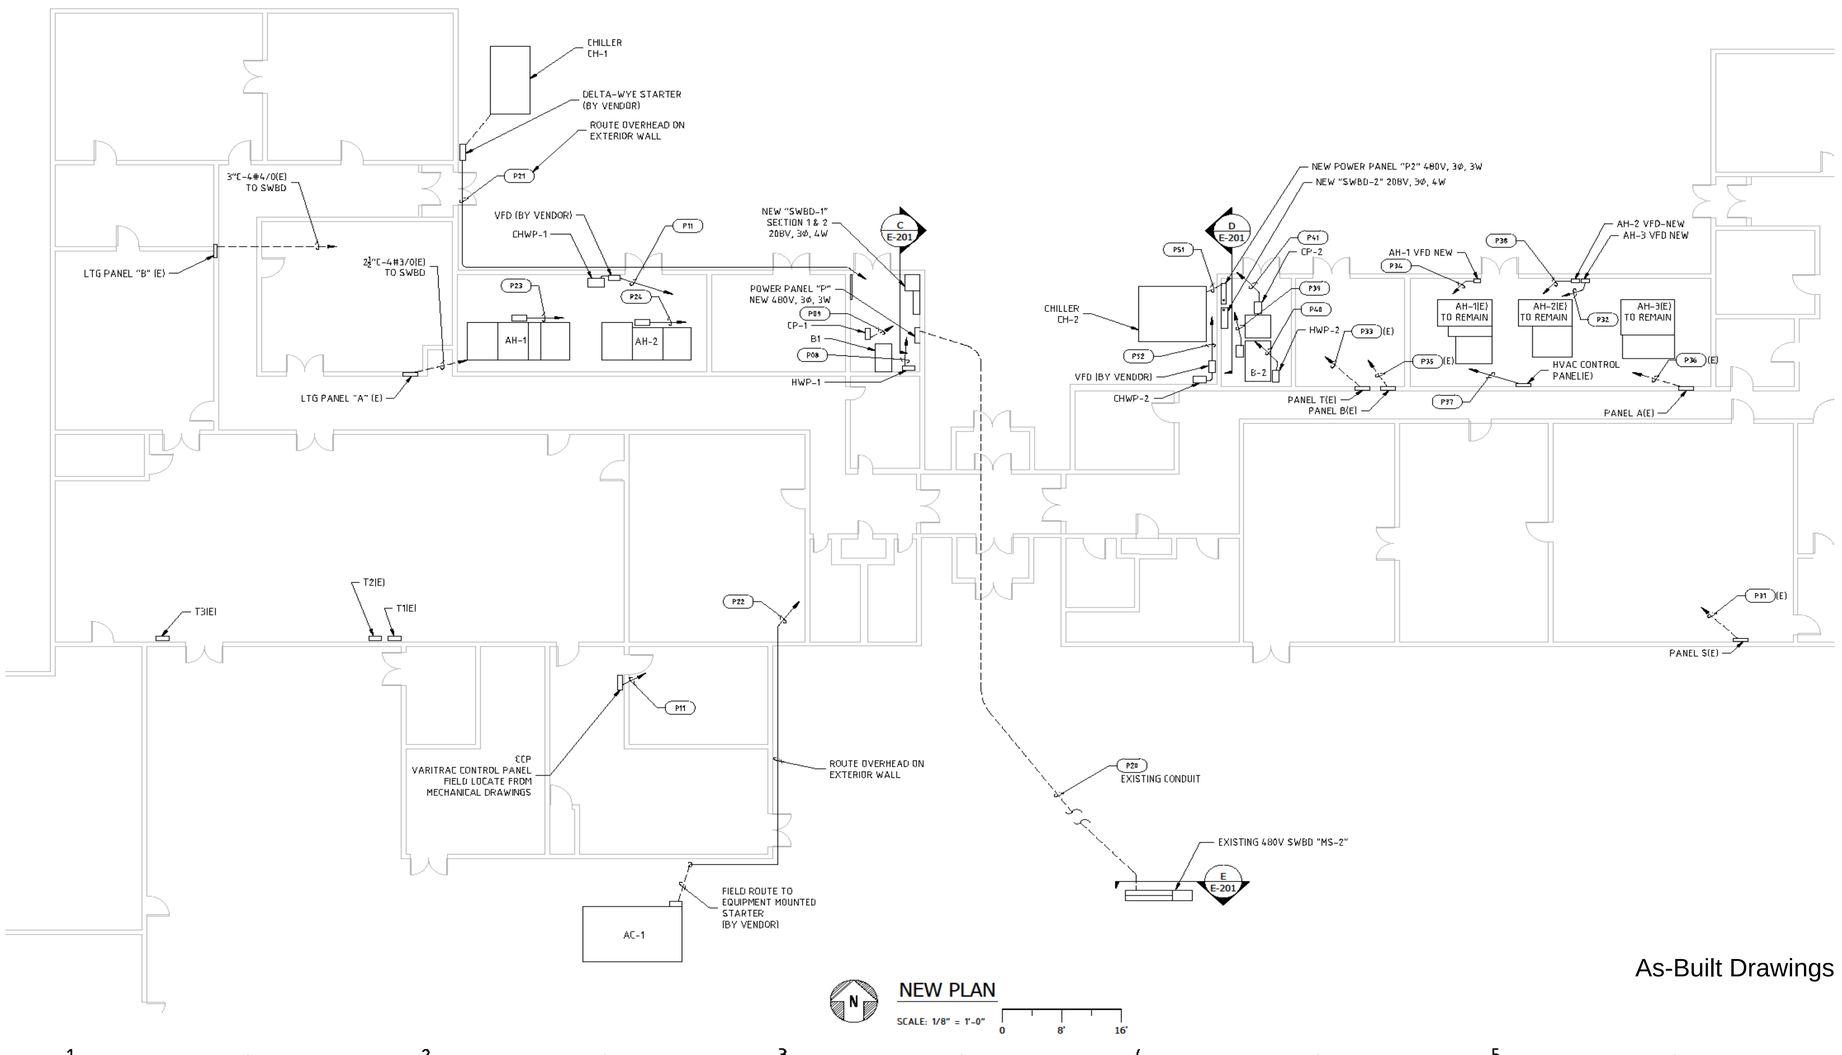

NEW PLAN

SCALE: 1/8" = 1'-0"

0 8' 16'

As-Built Drawings

POWER ENGINEERING SERVICES INCORPORATED
2703 SATURN STREET
BREA, CA 92821
TEL: (714) 524-9100

CONSULTANTS

REGISTERED PROFESSIONAL ENGINEER THOMAS M. HILL E-8615 Exp. 08-30-10 ELECTRICAL STATE OF CALIFORNIA

POJOAQUE PUEBLO SERVICES
435 CONTRACTORS HILL ROAD,
P.O. BOX 92
EDWARDS AIR FORCE BASE
CLIENT: CALIFORNIA 93523-8450

REPAIR HVAC BUILDING 1408

MARK	DATE	DESCRIPTION
	11/2009	As-Built Drawings
B	5/08/09	95% CD
A	12/19/08	65% CD

PROJECT NO. PES#4134
CAD DWG FILE: E-201 NEW PLAN.DWG
DRAWN BY:
CHKD BY:
COPYRIGHT:

SHEET TITLE
NEW PLAN

E-201
SHEET OF